



AS BUILT UTILITY PLAN
PHASE I

SCALE: 1" = 50'
DATE: FEBRUARY 1, 1990

U - 1A

REVISED:
BIRCH RUN AT SARATOGA
SARATOGA SPRINGS, NEW YORK

DEVELOPERS:
TOM LONGE
D. A. COLLINS CONSTRUCTION CO., INC.
MECHANICVILLE, NEW YORK 12118
(518) 684-9855

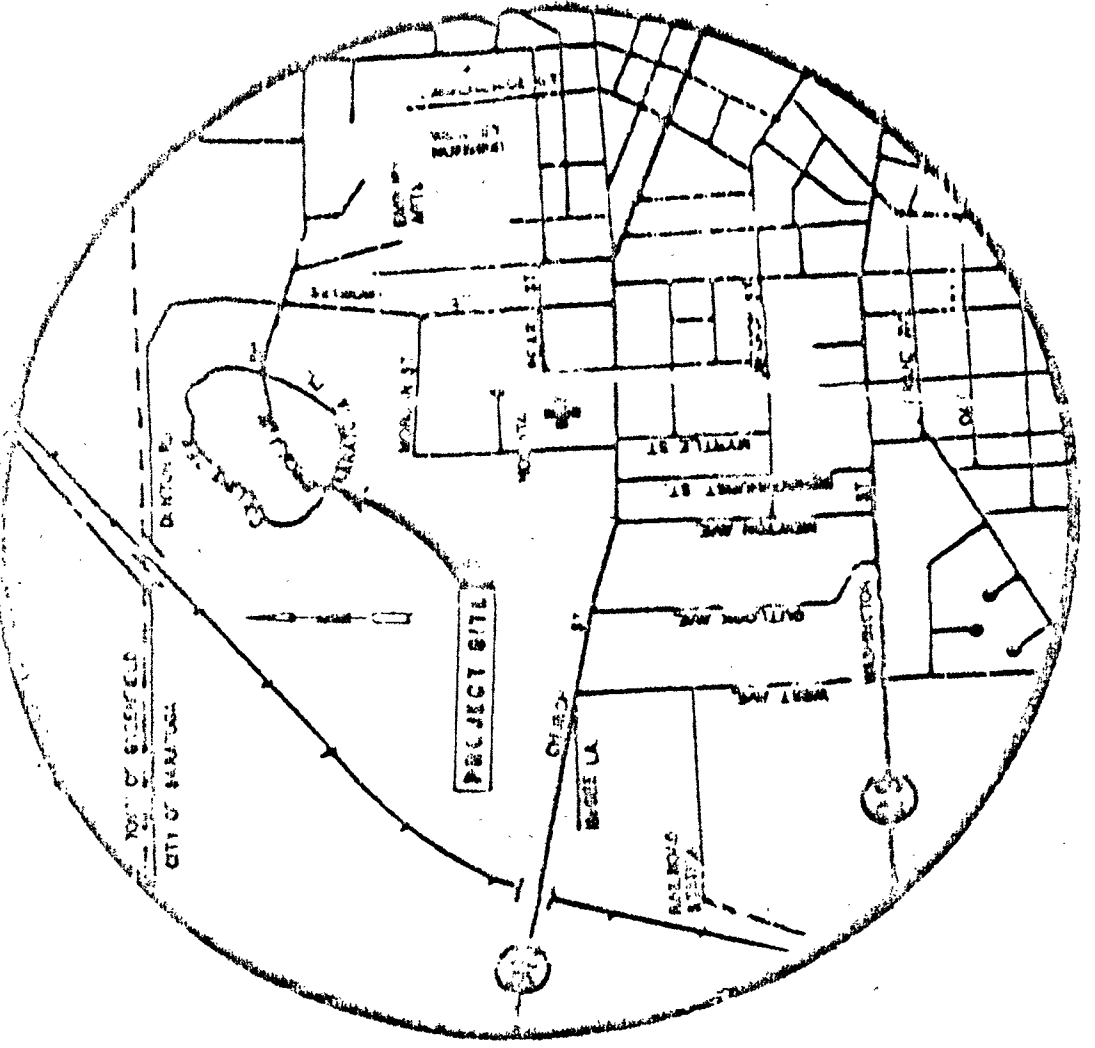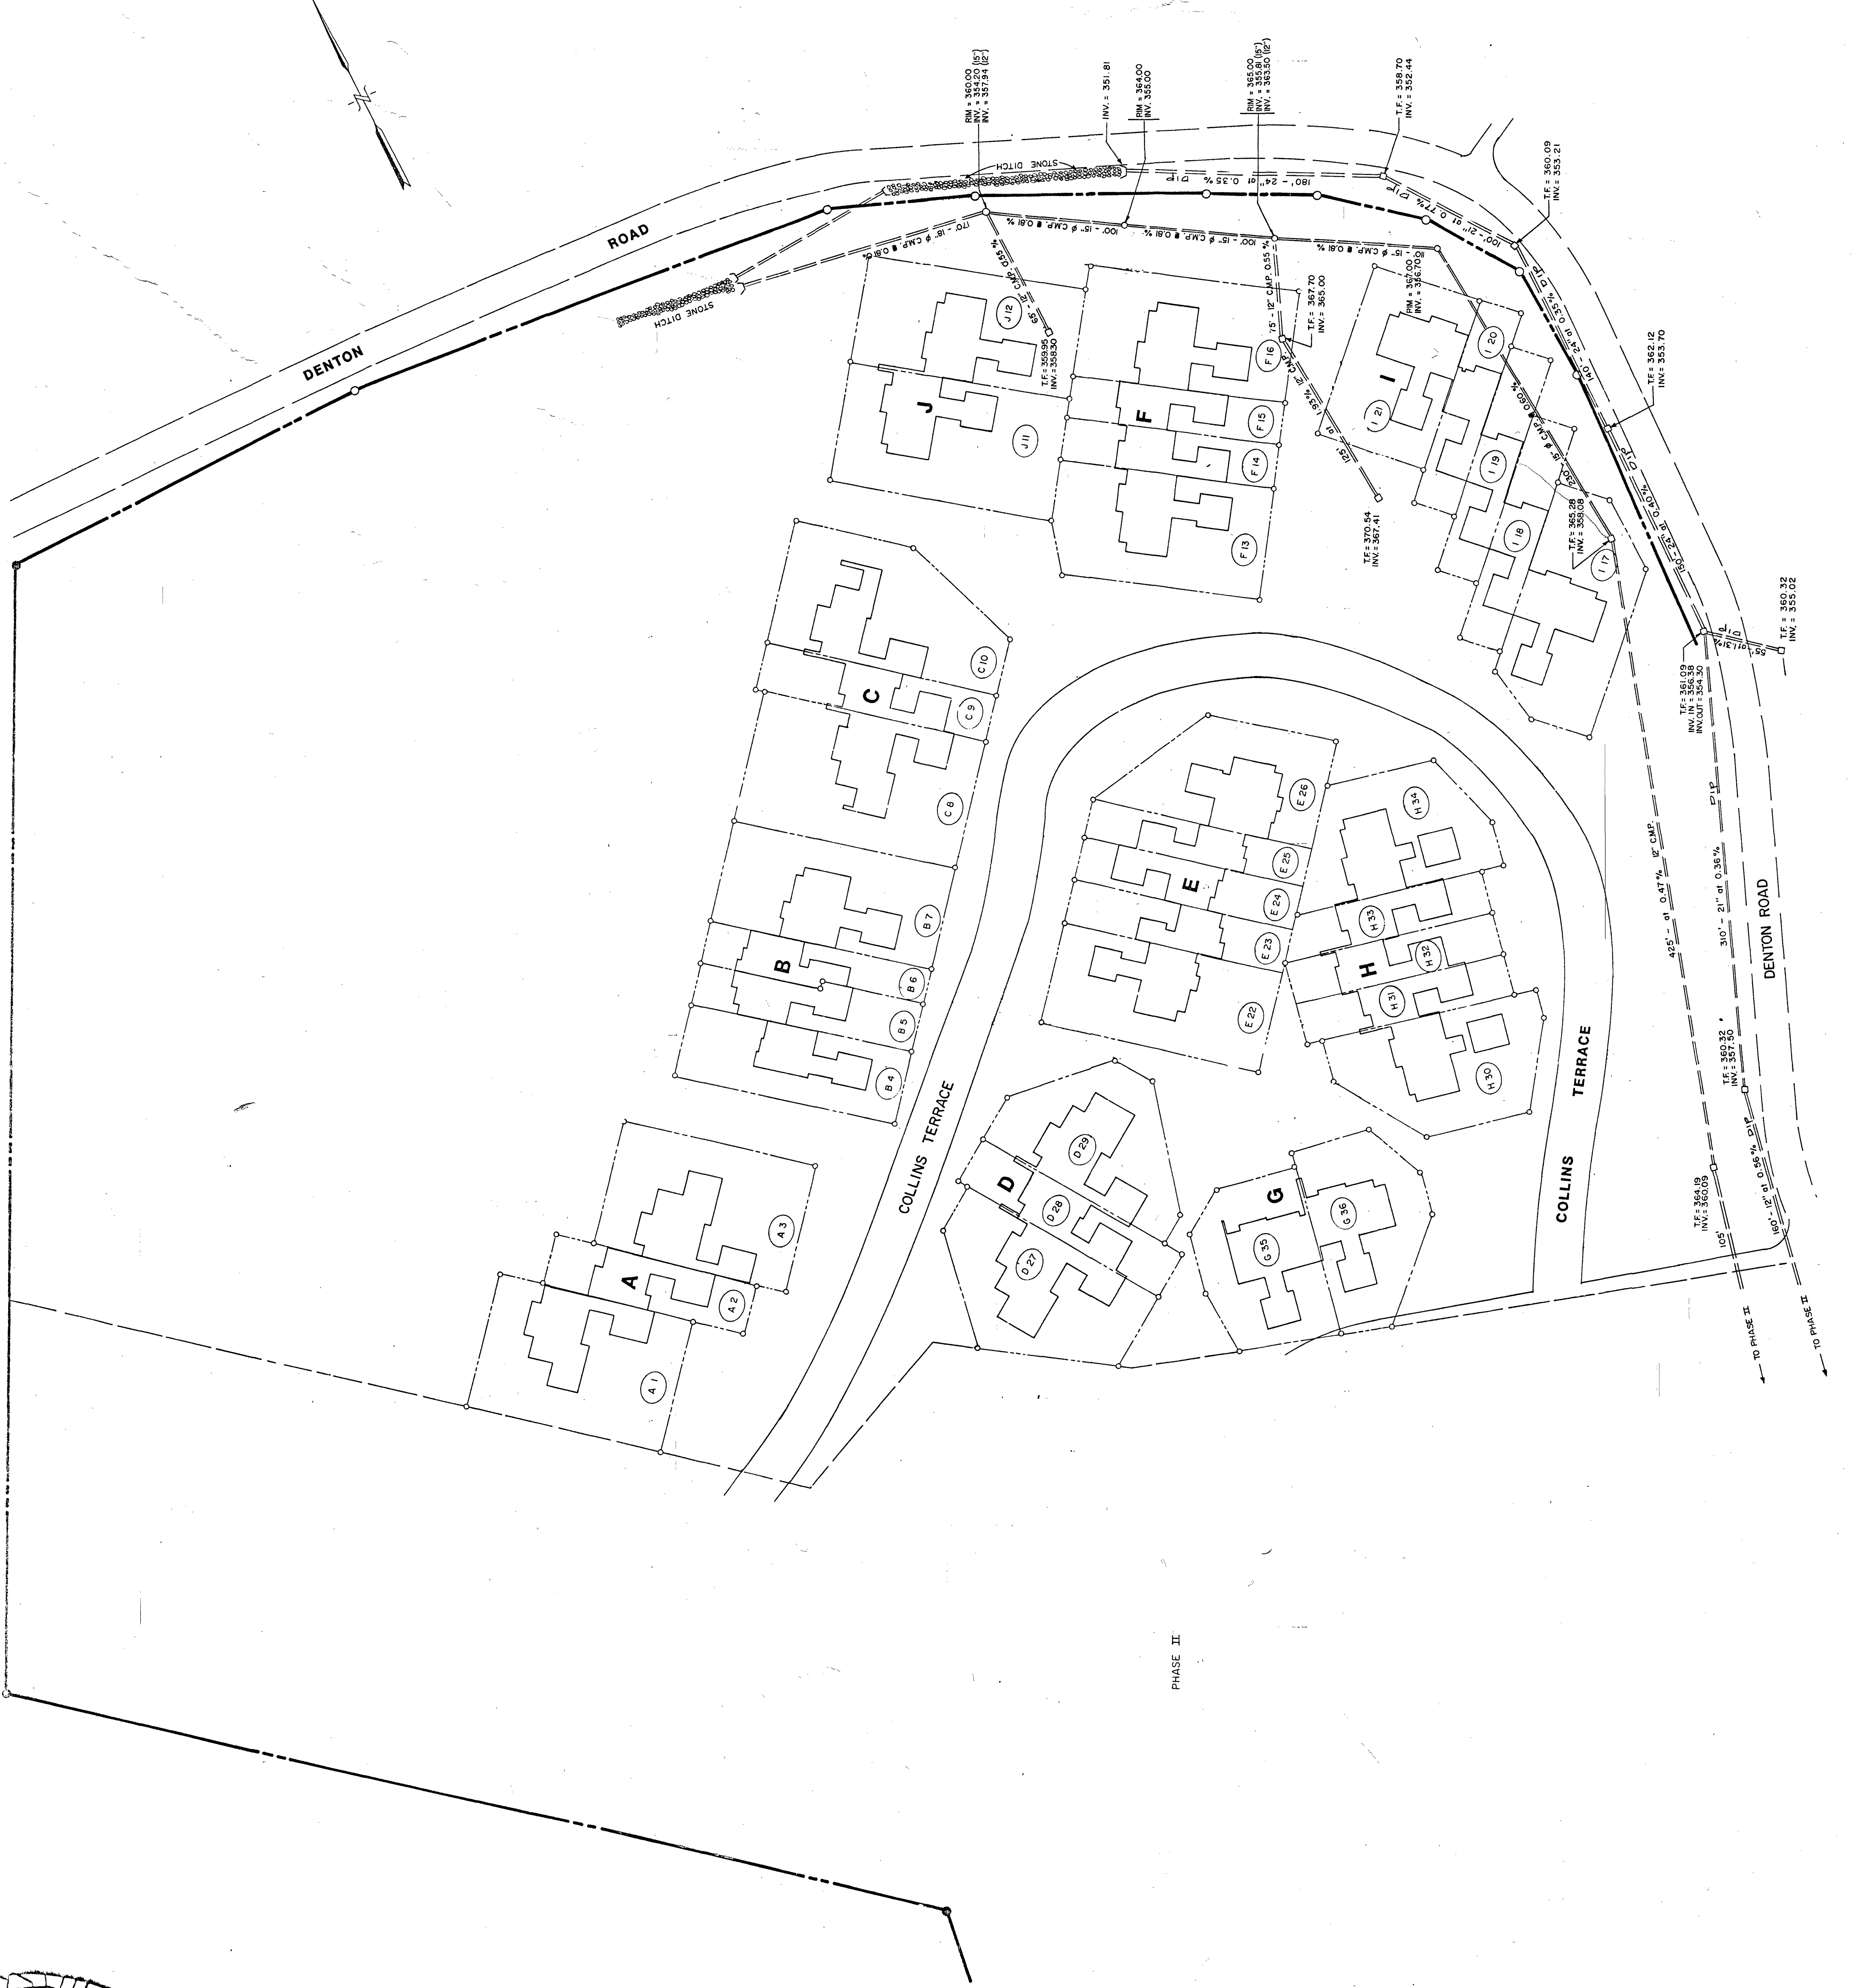

LOCATION MAP

PHASE II