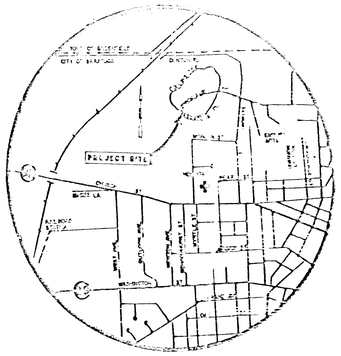

LOCATION MAP

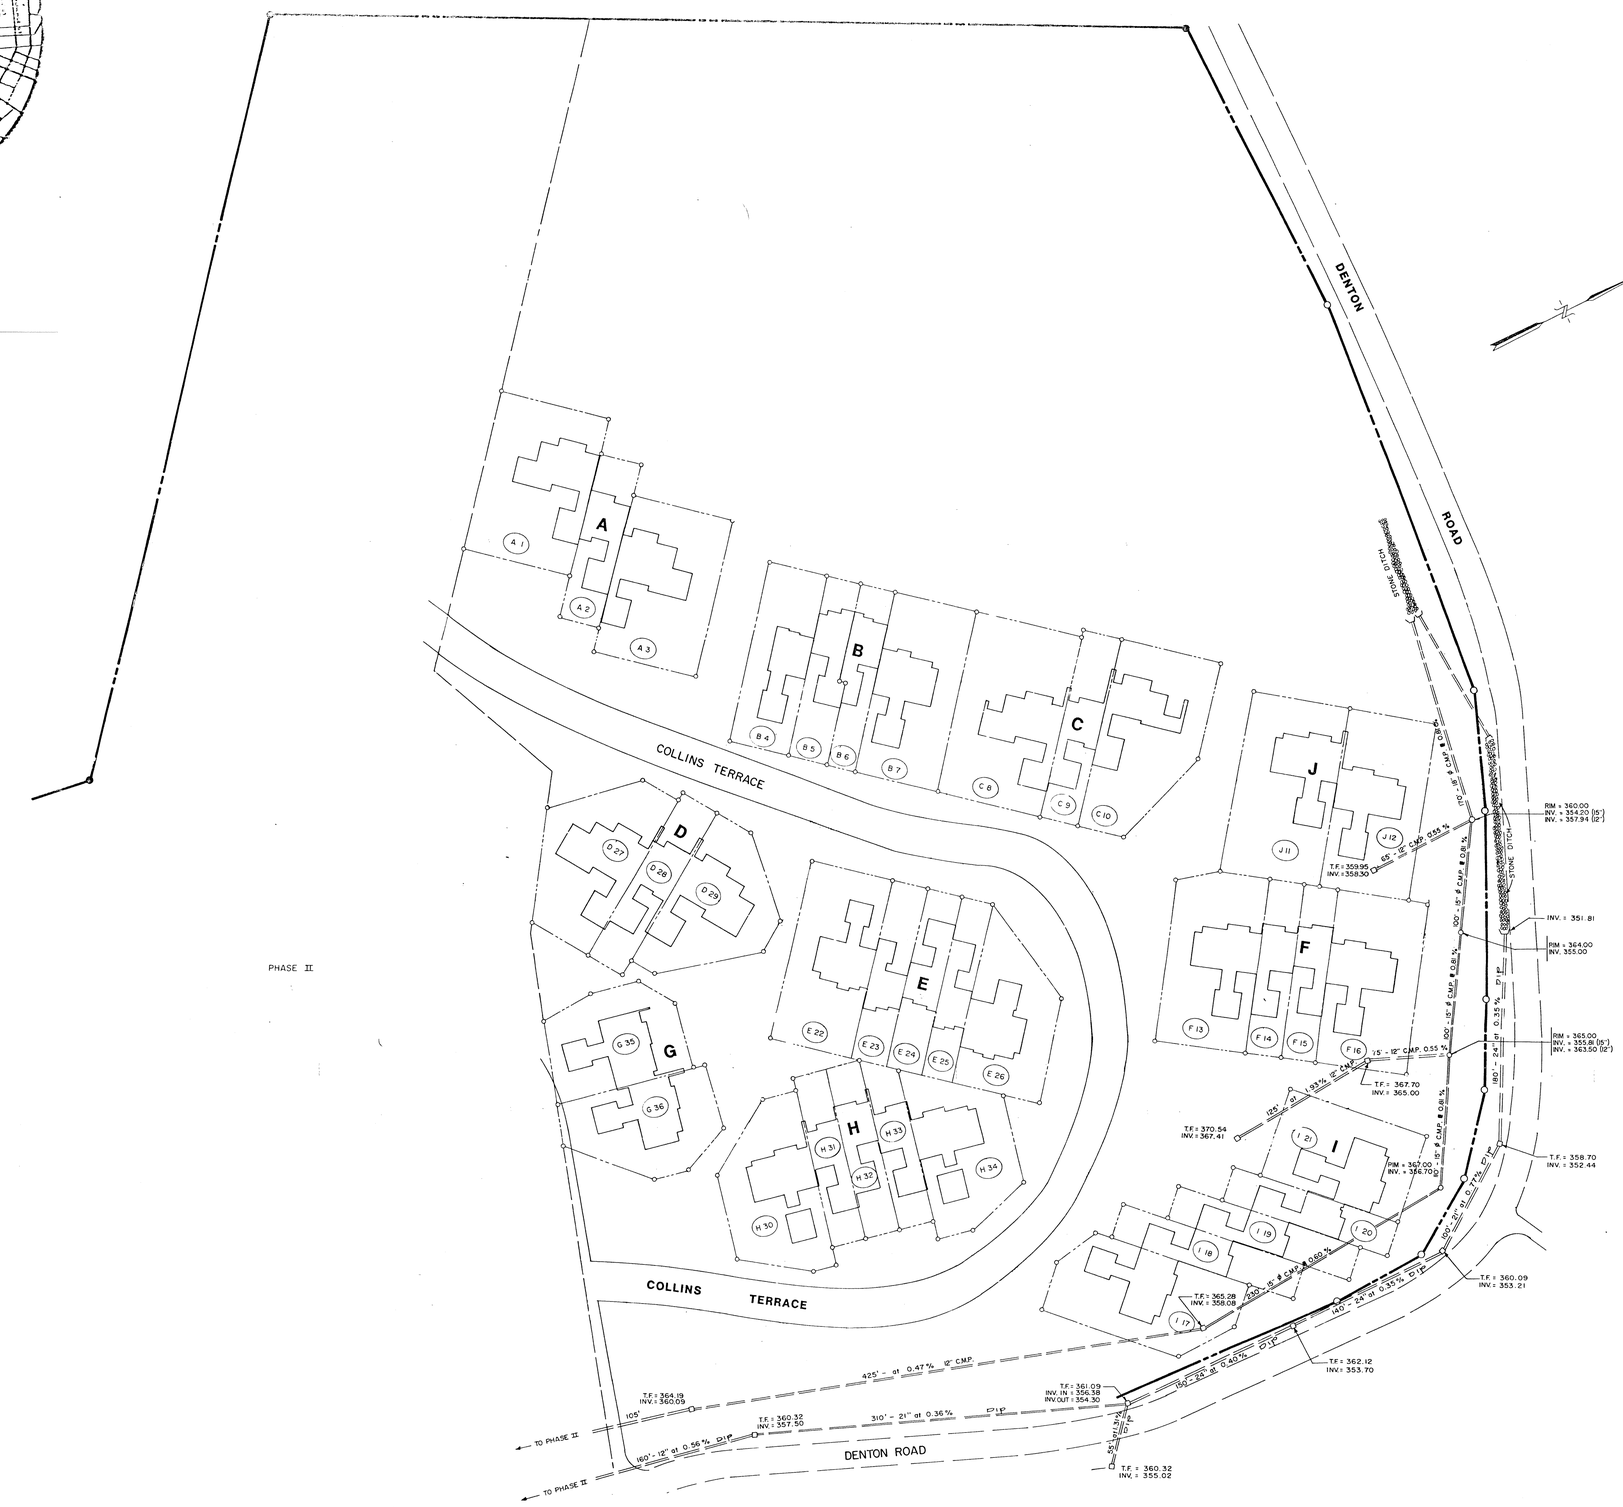

DEVELOPERS:
TOM LONGE
D. A. COLLINS CONSTRUCTION CO., INC.
MECHANICVILLE, NEW YORK 12118
(518) 884-9855

REVISED
BIRCH RUN AT SARATOGA
SARATOGA SPRINGS, NEW YORK

U - 1A

SCALE: 1" = 50'

DATE: FEBRUARY 1, 1990

AS BUILT UTILITY PLAN
STORM SEWER
PHASE I